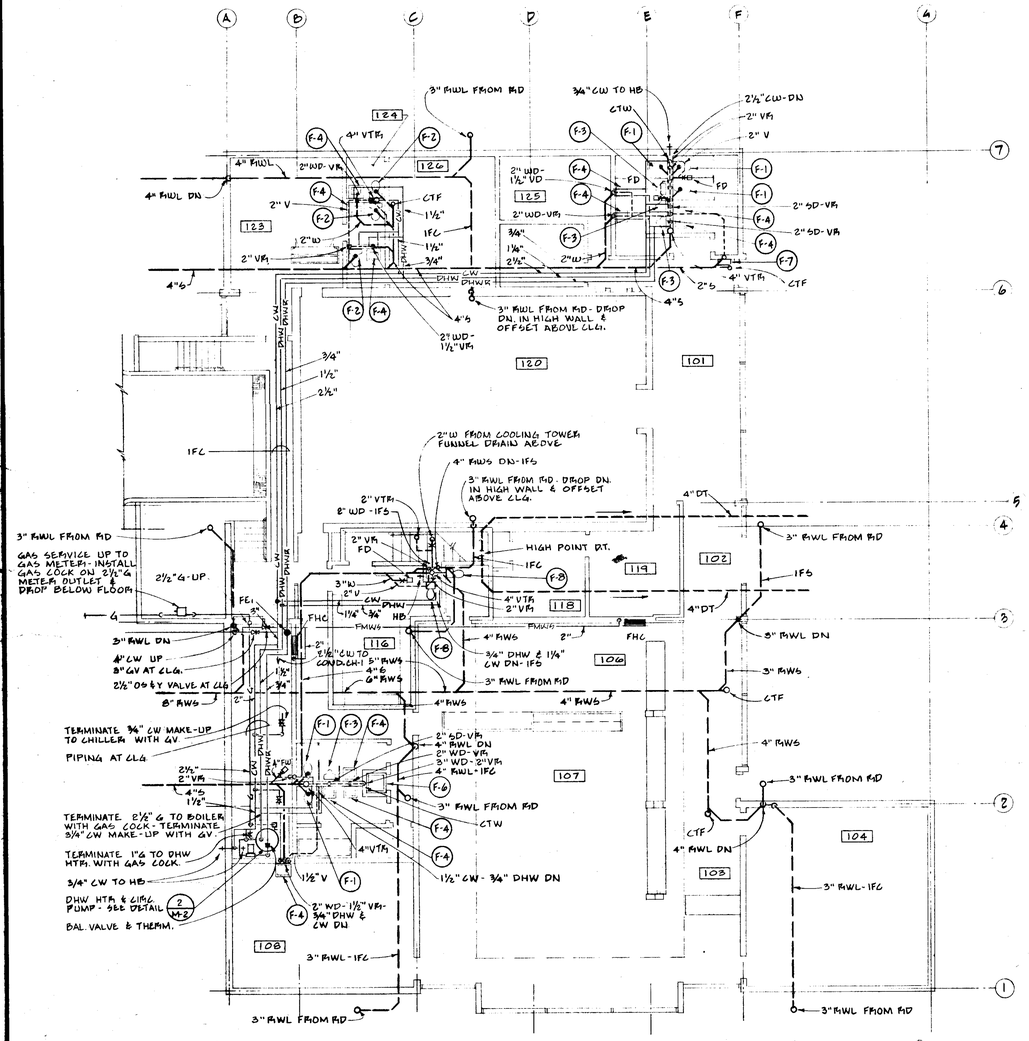

FIRST FLOOR PLAN - PLUMBING (1/M-3)

SCALE - 1/8" = 1'-0"

NOTE:
CHANGE ORDER NO. 11
OMIT TRAP PRIMERS FROM
4 FLOOR DRAINS

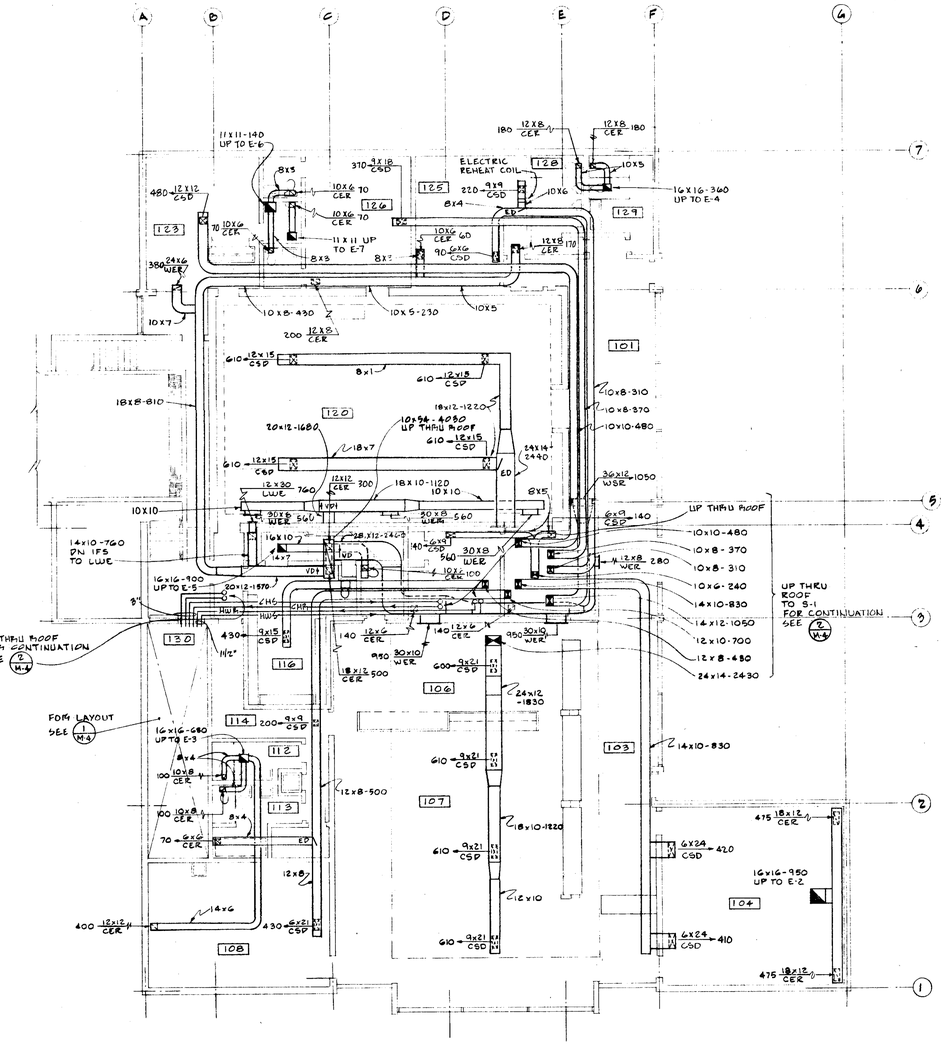

FIRST FLOOR PLAN-HEATING & VENTILATING (2/M-3)

SCALE ~ 1/8" = 1'-0"

SHEET NOTES

1. FOR SITE PLAN AND LEGEND, SEE SHEET M-1.
2. FOR SCHEDULES AND DETAILS, SEE SHEET M-2.
3. FOR PART PLANS AND DIAGRAMS, SEE SHEET M-4.

COUNTY OF ALAMEDA

SAN LEANDRO - HAYWARD MUNICIPAL COURT

999 EAST 14TH STREET
SAN LEANDRO, CALIFORNIA

CAMPBELL & WONG & ASSOCIATES

ARCHITECTURE & PLANNING

WORLEY K. WONG ARCHITECT, F.A.I.A.
JOHN CARDEN CAMPBELL A.I.D.
HARRY W. NAMITZ ARCHITECT, A.I.A.

737 BEACH STREET (415) 673-6604
SAN FRANCISCO 94109

BUONACCORSI AND ASSOCIATES
CONSULTING ENGINEERS
350 MISSION STREET SAN FRANCISCO 982-4370
A California Corporation furnishing professional engineering services under the immediate and responsible supervision of registered professional engineers.

REVISIONS

NO.	REVISION	BY	DATE

APPROVED FOR THE OWNER
BY:
APPROVED FOR THE ARCHITECTS
BY:

DRAWN BY	CHECKED BY
CED	JT
JOB NO.: 69-021-0	DATE: 16 NOV. 65

SHEET TITLE

- PLANS
- PLUMBING, HEATING & VENTILATING

M3

AS BUILT OCT 29 1973

SHEET 21 OF 26 SHEETS

CONTRACTOR SHALL VERIFY ALL MEASUREMENTS AND CONDITIONS AT THE JOB

DWG 826 CASE 901