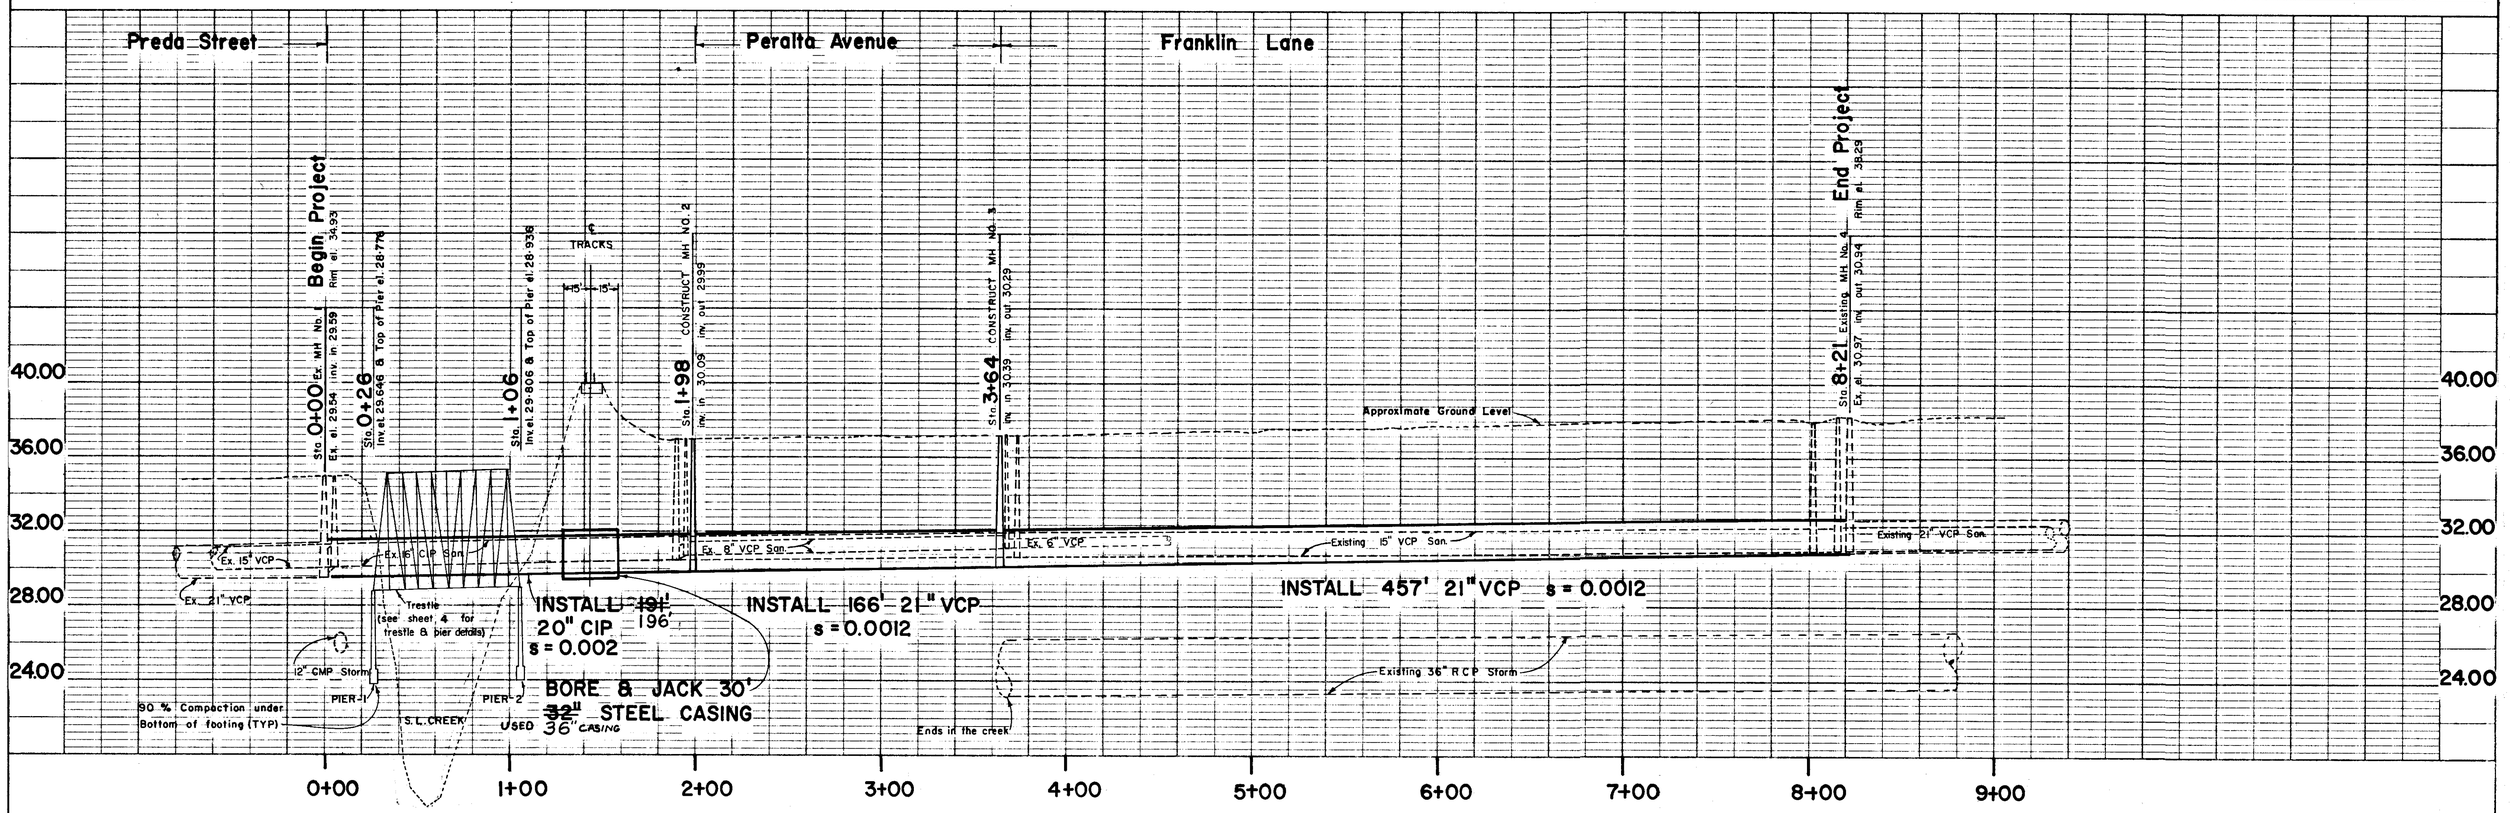

NOTE :- (1) BELL OF CIP SHALL NOT REST ON SUPPORTING ANGLES OF TRUSS
(2) TOP OF PIER NO-1 IS 2" LOWER THAN TOP OF PIER NO-2

PROFILE
(STATIONING ALONG ℄ OF SEWER)

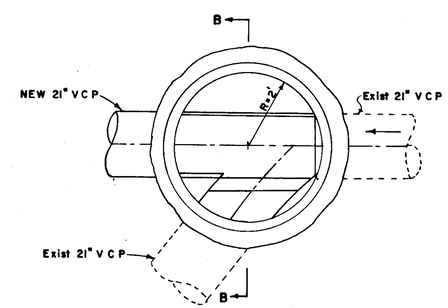

M.H. BOTTOM PLAN
SCALE 1/2" = 1'-0"

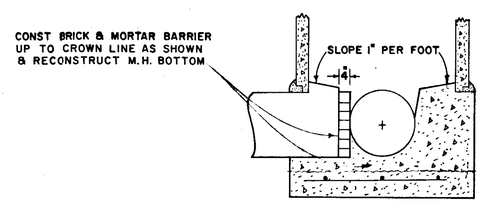

SECTION-BB
SCALE 1/2" = 1'-0"

AS BUILT
5-22-74 BEN & SHB
REFERENCE FIELD BOOK - 58

PUBLIC WORKS DEPARTMENT — CITY OF SAN LEANDRO

NO	DATE	REVISION

IT SHALL BE THE CONTRACTOR'S RESPONSIBILITY TO DETERMINE THE EXISTENCE AND LOCATION OF ALL UNDERGROUND UTILITIES. THOSE SHOWN DEPENDENT THE BEST INFORMATION AVAILABLE TO THE CITY OF SAN LEANDRO AT THE TIME OF TRANSLATION OF THESE PLANS. NO GUARANTEE IS MADE AS TO THE ACCURACY OF THIS INFORMATION.

DESIGNER Harper & Jhala
DRAFTSMAN Harper & Jhala
SR. ENG'R [signature]
ASST. P.W. DIR. [signature]
APPROVAL DATE 12-7-73
[signature]
PROJECT ENGINEER
Public Works Director
R.C.E. No. 8375

PREDA FRANKLIN SEWER
PROFILE

SHEET 3 OF 4
JOB NO. 73-635
SCALE V:1" = 4' H:1" = 40'
DWG. 188 CASE 505